CORNER RECORD


Agency Index CR-26-307

Document Number

City of Stockton County of San Joaquin, California

Brief Legal Description Found 1" Iron Pipe at northwest corner of parcel delineated as OR-236-81 in R.S. 6-304, S.J.C.R.

CORNER TYPE

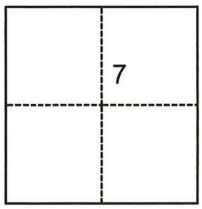

- ☐ Government Corner
- ☐ Meander
- ☐ Rancho
- ☐ Control
- ☒ Property
- ☐ Other

Date of Survey December 6, 2024

COORDINATES (Optional)

N. E.

Elevation

Units ☐ Metric ☐ U.S. Survey Foot

Horizontal Datum

Zone Epoch Date

Vertical Datum

☐ Complies with Public Resources Code §§8801-8819

☐ Complies with Public Resources Code §§8890-8902

PLS Act Ref.:	☐ 8765(d)	☒ 8771	☐ 8773	☐ Other:
Corner/ Monument:	☒ Left as found	☐ Established	☐ Rebuilt	☒ Pre-Construction
	☐ Found and tagged	☐ Reestablished	☐ Referenced	☐ Post-Construction

Narrative of corner identified and monument as found, set, reset, replaced, or removed:

☑ See sheet #2 for description(s):

LICENSED LAND SURVEYOR JOE MURPHY No. 7269 EXP. 12-31-26 STATE OF CALIFORNIA 9-16-26

SURVEYOR'S STATEMENT

This Corner Record was prepared by me or under my direction in conformance with the Professional Land Surveyors' Act on September 16, 2026.

Signed P.L.S. or R.C.E. No. 7269

COUNTY SURVEYOR'S STATEMENT

This Corner Record was received September 17, 2026

and examined and filed October 1, 2026.

Signed P.L.S. or ~~R.C.E.~~ No. 9728

Title County Surveyor

PROFESSIONAL LAND SURVEYOR ROBERT L. BORSDORF III LICENSE No. 9728 STATE OF CALIFORNIA

County Surveyor's Comment

Document Number

Agency Index


SCALE: 1" = 60'

REFERENCES

(R1) P.M. 25–186, S.J.C.R.
(R2) R.S. 6–304, S.J.C.R.

LEGEND

	FOUND MONUMENT AS NOTED
	BOUNDARY
FD.	FOUND
(M)	MEASURED
P.M.	PARCEL MAP
R.S.	RECORD OF SURVEY
S.J.C.R.	SAN JOAQUIN COUNTY RECORDS
SNF	SEARCHED NOT FOUND

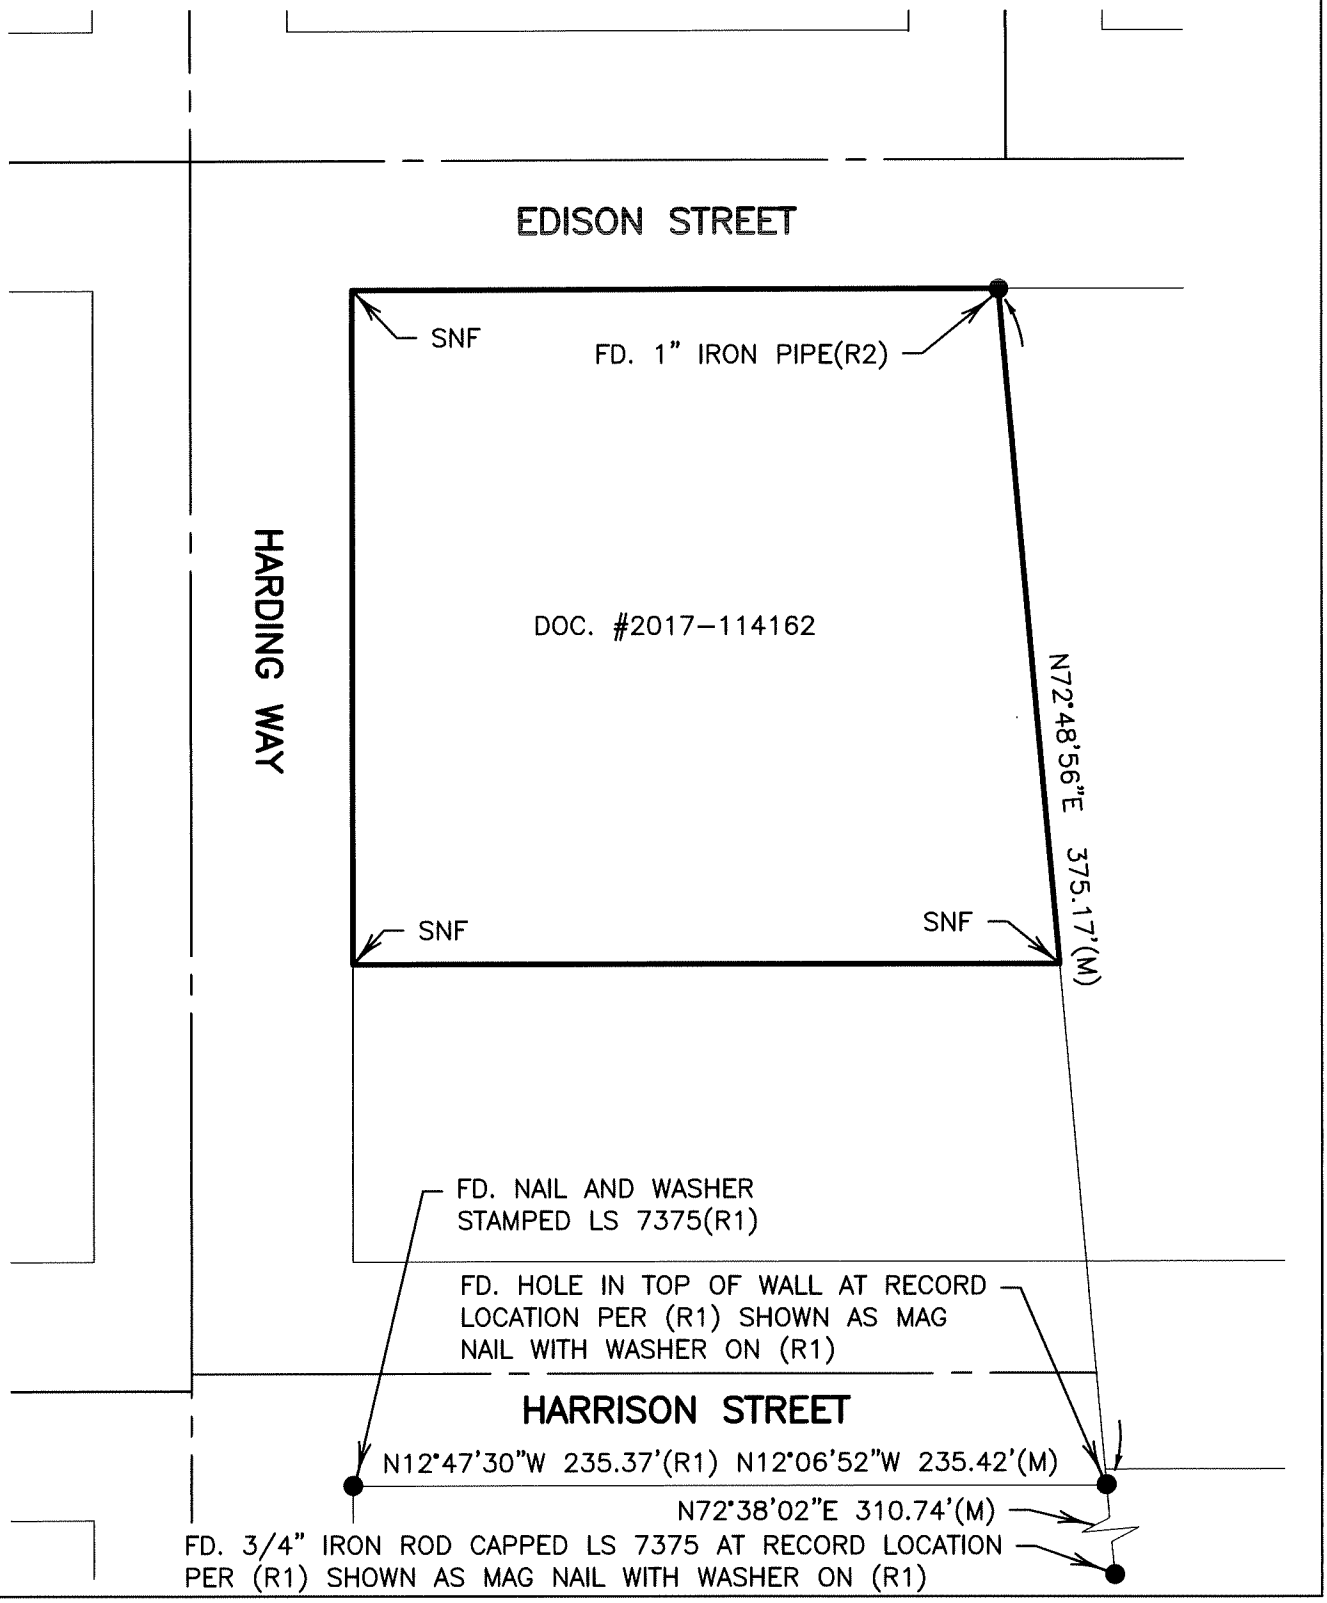

S:\2024\24162\MONUMENT PRESERVATION\Corner Record.dwg Aug 20, 2026