
CORNER RECORD

Agency Index CR-26-308

Document Number

City of _____ County of SAN JOAQUIN, California

Brief Legal Description WOLFE ROAD @ OTT ROAD
WITHIN SECTION F, C.M. WEBER GRANT

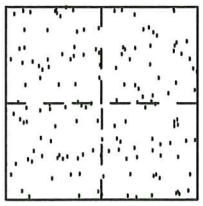

CORNER TYPE

- ☐ Government Corner
- ☐ Control
- ☐ Meander
- ☐ Property
- ☐ Rancho
- ☒ Other

Date of Survey 8-14-2026

COORDINATES (Optional)

N. _____ E. _____
Elevation. _____
Units ☐ Metric ☒ U.S. Survey Foot
Horizontal Datum _____
Zone _____ Epoch Date _____
Vertical Datum _____
☐ Complies with Public Resources Code §§8801-8819
☐ Complies with Public Resources Code §§8890-8902

PLS Act Ref.:	☐ **8765(d)**	☒ **8771**	☐ **8773**	☐ **Other:**
Corner/ Monument:	☐ Left as found	☐ Established	☐ Rebuilt	☒ Pre-Construction
	☐ Found and tagged	☒ Reestablished	☐ Referenced	☐ Post-Construction

Narrative of corner identified and monument as found, set, reset, replaced, or removed:
☒ See sheet #2 for description(s):

SEARCHED FOR AND DID NOT FIND MAG NAIL AS DESCRIBED IN CORNER RECORD CR-12-390

FOUND EXISTING TIES PER CORNER RECORD CR-12-390 AND RESET NAIL IN ASPHALT, SET ADDITIONAL TIES AS DESCRIBED ON SHEET 2

MONUMENTS LOCATED PRIOR TO CONSTRUCTION OF PG&E FACILITIES

SURVEYOR'S STATEMENT

This Corner Record was prepared by me or under my direction in conformance with the Professional Land Surveyor's Act on SEPTEMBER 17, 2026.

Signed Randall Scott West P.L.S. or ~~R.C.E.~~ No. 8663

PROFESSIONAL LAND SURVEYOR
RANDELL SCOTT WEST
No. 8663
STATE OF CALIFORNIA

COUNTY SURVEYOR'S STATEMENT

This Corner Record was received SEPTEMBER 24, 2026

and examined and filed OCTOBER 12, 2026.

Signed RBB III P.L.S. or ~~R.C.E.~~ No. 9728

Title County Surveyor

County Surveyor's Comment


PROFESSIONAL LAND SURVEYOR
ROBERT L. BORSDORF III
LICENSE No. 9728
STATE OF CALIFORNIA

LEGEND:

⊙	INDICATES SET MAG NAIL IN ASPHALT PER CR–12–390
◎	INDICATES SET NAIL AND SHINER ON ELECTRIC POWER POLE
◉	INDICATES FOUND NAIL AND SHINER ON ELECTRIC POWER POLE
— · —	EDGE OF PAVEMENT
— ·· —	RIGHT OF WAY
(M)	MEASURED DISTANCE
(R)	REFERENCED TO CR–12–390, S.J.C.S.R.
S.J.C.S.R.	SAN JOAQUIN COUNTY SURVEYOR'S RECORDS

N

SCALE:
1"=60'

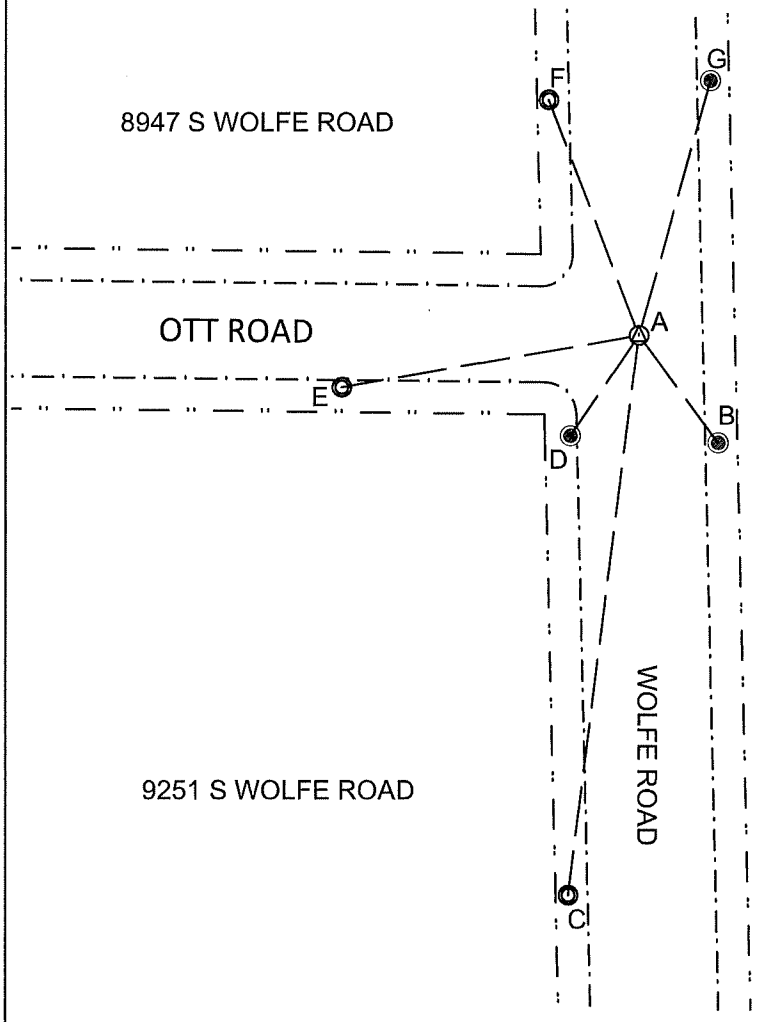

POINT	(M)	(R)
A–B	41.73'	41.73'
A–C	175.97'	–
A–D	39.11'	39.18'
A–E	94.25'	–
A–F	78.58'	–
A–G	82.43'	82.44