
CORNER RECORD

Agency Index CR-26-309

Document Number

City of _____ County of San Joaquin, California

Brief Legal Description PARCEL 1, R.S. 20-69

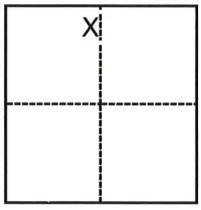

CORNER TYPE

- ☐ Government Corner
- ☐ Control
- ☐ Meander
- ☒ Property
- ☐ Rancho
- ☐ Other

Date of Survey July 7, 2026

Sec. 14, T.2S R.9E., M.D.B.&M.

COORDINATES (Optional)

N. _____ E. _____

Elevation _____

Units ☐ Metric ☒ U.S. Survey Foot

Horizontal Datum _____

Zone _____ Epoch Date _____

Vertical Datum _____

☐ Complies with Public Resources Code §§8801-8819

☐ Complies with Public Resources Code §§8890-8902

PLS Act Ref.:	☐ **8765(d)**	☒ **8771**	☐ **8773**	☐ **Other:**
Corner/ Monument:	☒ Left as found	☐ Established	☐ Rebuilt	☒ Pre-Construction
	☐ Found and tagged	☐ Reestablished	☐ Referenced	☐ Post-Construction

Narrative of corner identified and monument as found, set, reset, replaced, or removed:

☑ See sheet #2 for description(s):

THIS MONUMENT HAS BEEN REFERENCED PRIOR TO CONSTRUCTION. THE TIES SHOWN HEREON ARE FOR THE PURPOSE OF PERPETUATING THE FOUND MONUMENT AND NO CLAIM IS MADE TO THEIR RELATIONSHIP TO THE BOUNDARY LOCATION SHOWN HEREON.

SURVEYOR'S STATEMENT

This Corner Record was prepared by me or under my direction in conformance with the Professional Land Surveyors' Act on September 18, 2026.

Signed _____ P.L.S. or R.C.E. No. 7269

LICENSED LAND SURVEYOR JOE MURPHY No. 7269 EXP. 12-31-26 STATE OF CALIFORNIA 9-13-26

COUNTY SURVEYOR'S STATEMENT

This Corner Record was received September 24, 2026

and examined and filed OCTOBER 12, 2026

Signed _____ III P.L.S. ~~or R.C.E.~~ No. 9728

Title County Surveyor

County Surveyor's Comment

PROFESSIONAL LAND SURVEYOR ROBERT L. BORSDORF III LICENSE No. 9728 STATE OF CALIFORNIA

LEGEND

●———	FD. MONUMENT AS NOTED
———	BOUNDARY
— – —	CENTER LINE
℄	CENTER LINE
⊗	SET SPIKE
-○-	EXISTING GATE POST
EX.	EXISTING
FD.	FOUND
R.S.	RECORD OF SURVEY
C.R.	CORNER RECORD, SAN JOAQUIN COUNTY SURVEYOR'S RECORDS
S.J.C.R.	SAN JOAQUIN COUNTY RECORDS
S.S.J.I.D.	SOUTH SAN JOAQUIN IRRIGATION DISTRICT

0 2.5 5 10


SCALE: 1"=5'

SCALE: N 1" = 5'

REFERENCES

(R1) R.S. 20–69, S.J.C.R.

(R2) C.R 21–082

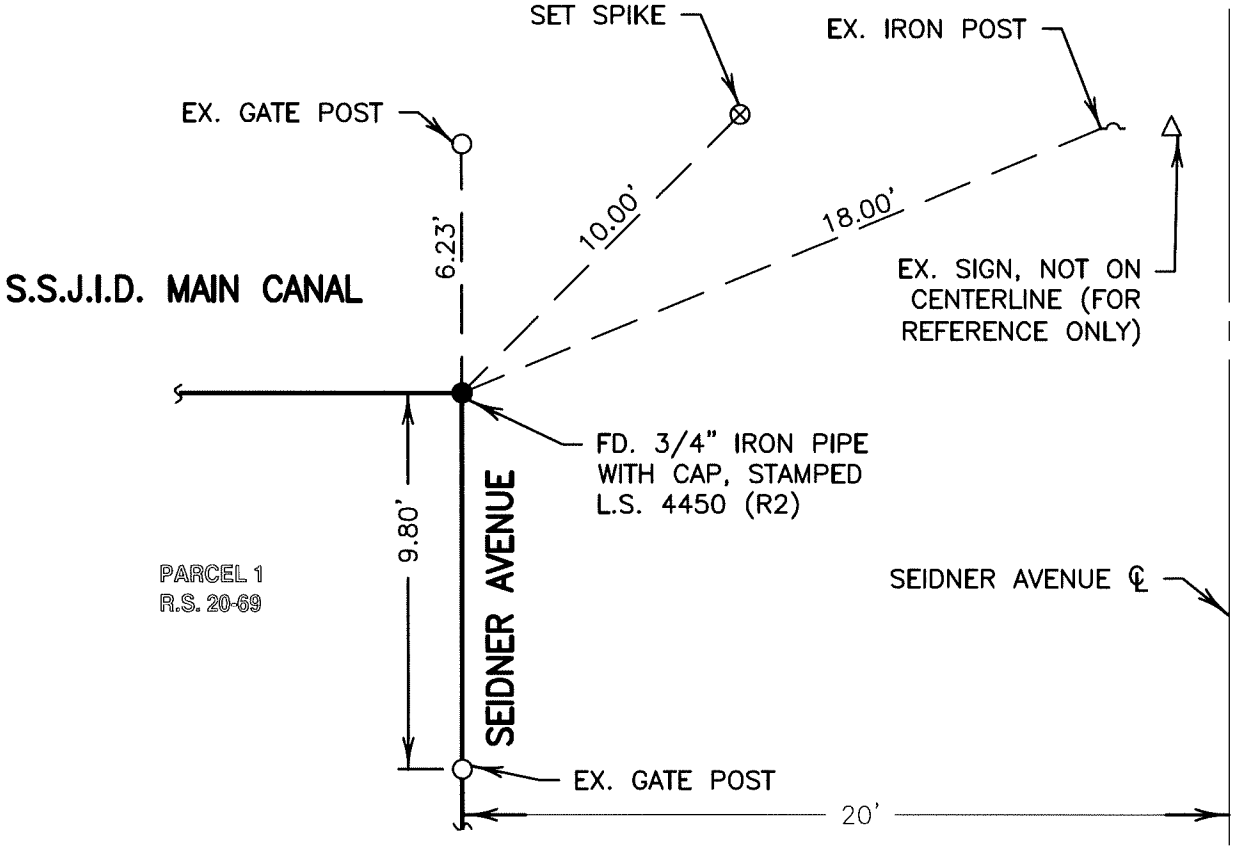

S:\2026\2672\Corner Record.dwg Aug 26, 2026