
CORNER RECORD

Agency Index CR-26-310

Document Number

City of _____ County of San Joaquin, California

Brief Legal Description San Jose Road @ Middle Road, (Within Rancho El Pescadero)

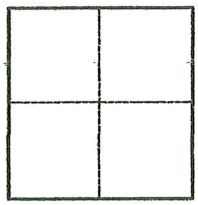

CORNER TYPE

- ☐ Government Corner
- ☐ Control
- ☐ Meander
- ☐ Property
- ☐ Rancho
- ☒ Other

Date of Survey December 2, 2025

COORDINATES (Optional)

N. _____ E. _____

Elevation _____

Units ☐ Metric ☒ U.S. Survey Foot

Horizontal Datum _____

Zone _____ Epoch Date _____

Vertical Datum _____

☐ Complies with Public Resources Code §§8801-8819

☐ Complies with Public Resources Code §§8890-8902

PLS Act Ref.:	☐ 8765(d)	☒ 8771	☐ 8773	☐ Other:
Corner/ Monument:	☒ Left as found	☐ Established	☐ Rebuilt	☒ Pre-Construction
	☐ Found and tagged	☐ Reestablished	☐ Referenced	☐ Post-Construction

Narrative of corner identified and monument as found, set, reset, replaced, or removed:

☑ See sheet #2 for description(s):

SURVEYOR'S STATEMENT

This Corner Record was prepared by me or under my direction in conformance with the Professional Land Surveyors' Act on December 16, 2025.

Signed _____ P.L.S. or ~~R.C.E. No.~~ 7268

PROFESSIONAL LAND SURVEYOR
KEVIN E. MORRIS
NO. 7268
STATE OF CALIFORNIA

COUNTY SURVEYOR'S STATEMENT

This Corner Record was received SEPTEMBER 24, 2026


and examined and filed OCTOBER 12, 2026

Signed _____ III P.L.S. or ~~R.C.E.~~ No. 9728


Title County Surveyor

County Surveyor's Comment

PROFESSIONAL LAND SURVEYOR
ROBERT L. BORSDORF III
LICENSE No. 9728
STATE OF CALIFORNIA

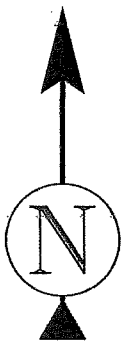

N.T.S.

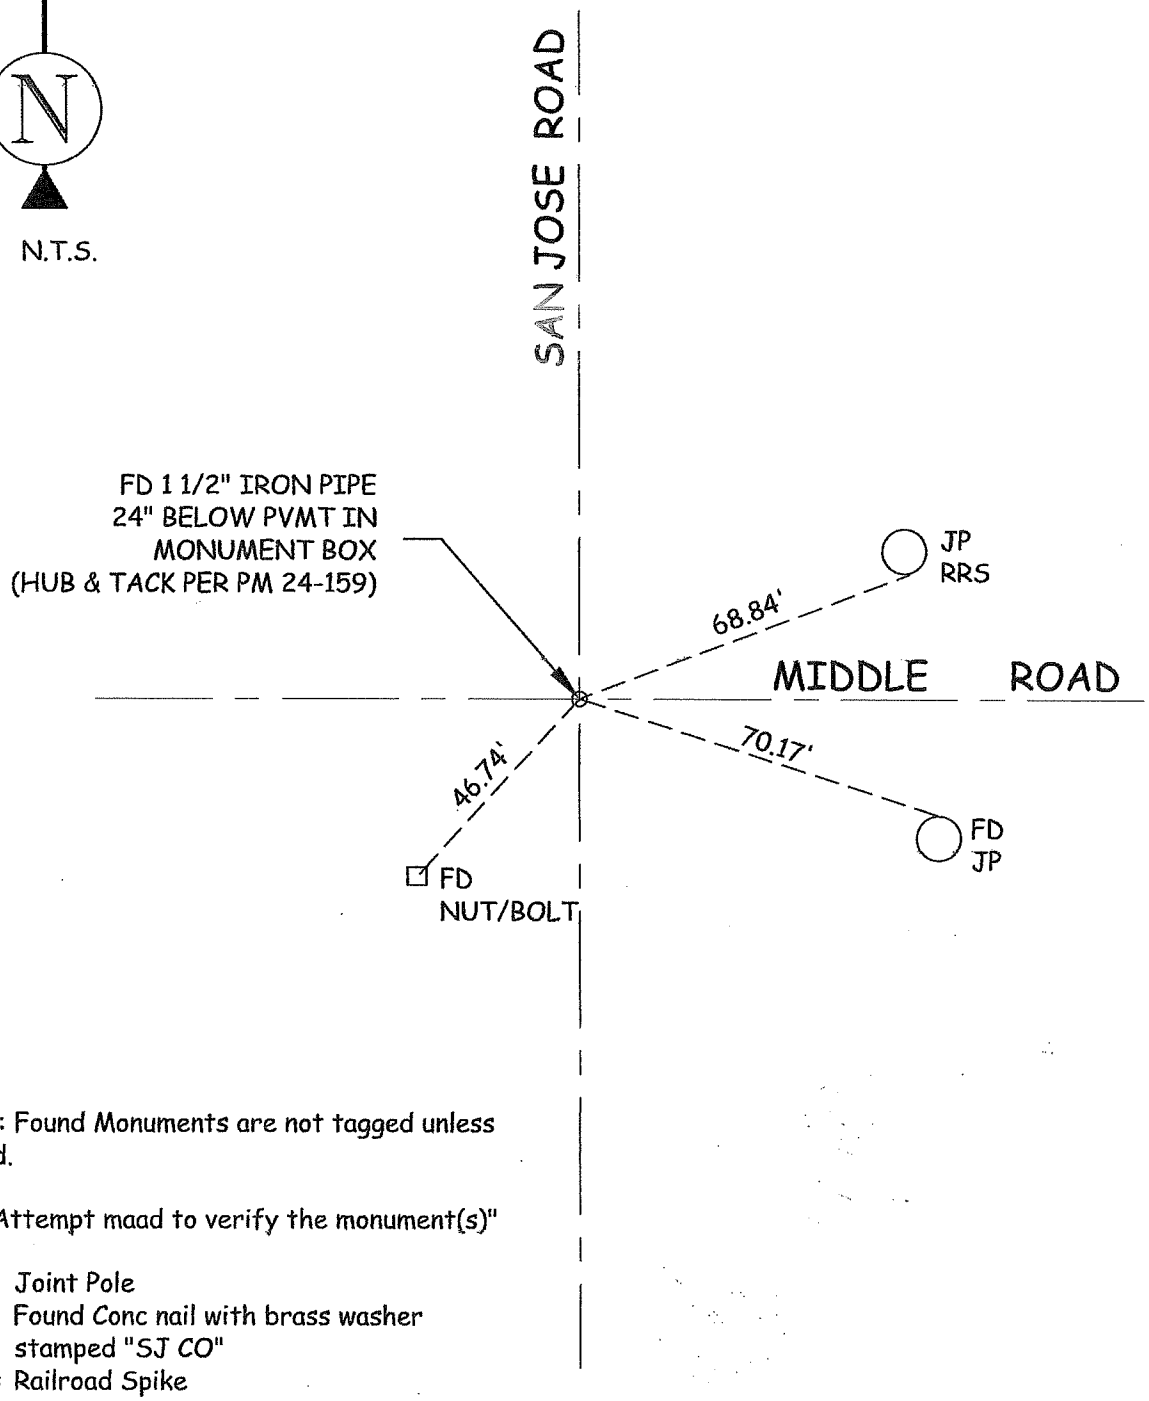

Note: Found Monuments are not tagged unless noted.

"No Attempt maad to verify the monument(s)"

JP= Joint Pole
FD = Found Conc nail with brass washer stamped "SJ CO"
RRS= Railroad Spike
NUT/BOLT = Nut and bolt affixed in concrete footer of iron fence
PVMT = Pavement
PM= Parcel Map