CORNER RECORD

Agency Index CR-26-311

Document Number

City of _____ County of San Joaquin, California

Brief Legal Description Reeve Road @ Middle Road, (Within Rancho El Pescadero)

CORNER TYPE

☐ Government Corner ☐ Control
☐ Meander ☐ Property
☐ Rancho ☒ Other

Date of Survey December 2, 2025

COORDINATES (Optional)

N. _____ E. _____
Elevation _____
Units ☐ Metric ☒ U.S. Survey Foot
Horizontal Datum _____
Zone _____ Epoch Date _____
Vertical Datum _____
☐ Complies with Public Resources Code §§8801-8819
☐ Complies with Public Resources Code §§8890-8902

PLS Act Ref.:	☐ 8765(d)	☒ 8771	☐ 8773	☐ Other:
Corner/ Monument:	☒ Left as found	☐ Established	☐ Rebuilt	☒ Pre-Construction
	☐ Found and tagged	☐ Reestablished	☐ Referenced	☐ Post-Construction

Narrative of corner identified and monument as found, set, reset, replaced, or removed:
☑ See sheet #2 for description(s):

SURVEYOR'S STATEMENT

This Corner Record was prepared by me or under my direction in conformance with the Professional Land Surveyors' Act on January 22, 2025.

Signed _____ P.L.S. or ~~R.C.E. No.~~ 7268

PROFESSIONAL LAND SURVEYOR
KEVIN MORRIS
NO. 7268
STATE OF CALIFORNIA

COUNTY SURVEYOR'S STATEMENT

This Corner Record was received SEPTEMBER 24, 2026


and examined and filed OCTOBER 12, 2026

Signed RBB III P.L.S. or ~~R.C.E. No.~~ 9728

Title County Surveyor

County Surveyor's Comment

PROFESSIONAL LAND SURVEYOR
ROBERT L. BORSDORF III
LICENSE No. 9728
STATE OF CALIFORNIA

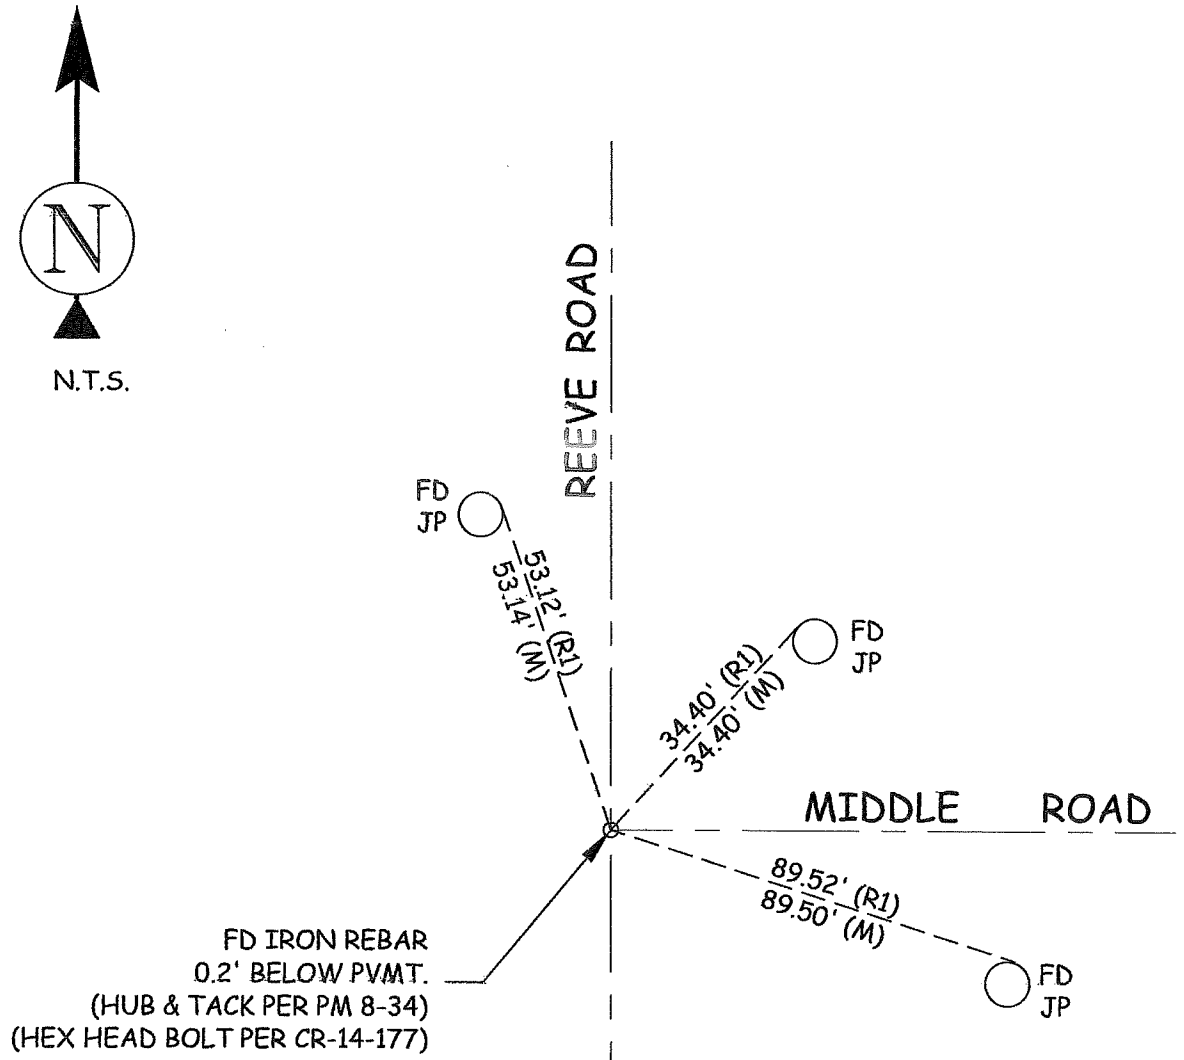

Note: Found Monuments are not tagged unless noted.

"No Attempt made to verify the monument(s)"

JP= Joint Pole
FD = Found Conc nail with brass washer stamped "SJ CO"
PM= Parcel Map
PVMT = Pavement

R1 = Corner record - CR-14-177