
CORNER RECORD

Agency Index CR-26-314

Document Number

City of Stockton County of San Joaquin, California

Brief Legal Description Monuments found at the intersection of Channel Street and American Street.

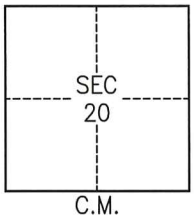

C.M.
WEBER
GRANT

CORNER TYPE

- ☐ Government Corner
- ☐ Control
- ☐ Meander
- ☒ Property
- ☐ Rancho
- ☐ Other

Date of Survey July 22nd, 2025

COORDINATES (Optional)

N. E.

Elevation

Units ☐ Metric ☐ U.S. Survey Foot

Horizontal Datum

Zone Epoch Date

Vertical Datum

☐ Complies with Public Resourses Code §§8801-8819

☐ Complies with Public Resourses Code §§8890-8902

PLS Act Ref.:	☐ 8765(d)	☒ 8771	☐ 8773	☐ Other:
Corner/ Monument:	☒ Left as found	☐ Established	☐ Rebuilt	☒ Pre-Construction
	☐ Found and tagged	☐ Reestablished	☒ Referenced	☐ Post-Construction

Narrative of corner identified and monument as found, set, reset, replaced, or removed:

☒ See sheet #2 for description(s):

SURVEYOR'S STATEMENT

This Corner Record was prepared by me or under my direction in conformance with the Professional Land Surveyors' Act on SEPT. 21 ST, 2026

Signed P.L.S. or ~~R.C.E.~~ No. 8366



COUNTY SURVEYOR'S STATEMENT

This Corner Record was received SEPTEMBER 28, 2026

and examined and filed OCTOBER 12, 2026

Signed P.L.S. or R.C.E. No. 9728


Title County Surveyor

County Surveyor's Comment




Document Number

Agency Index

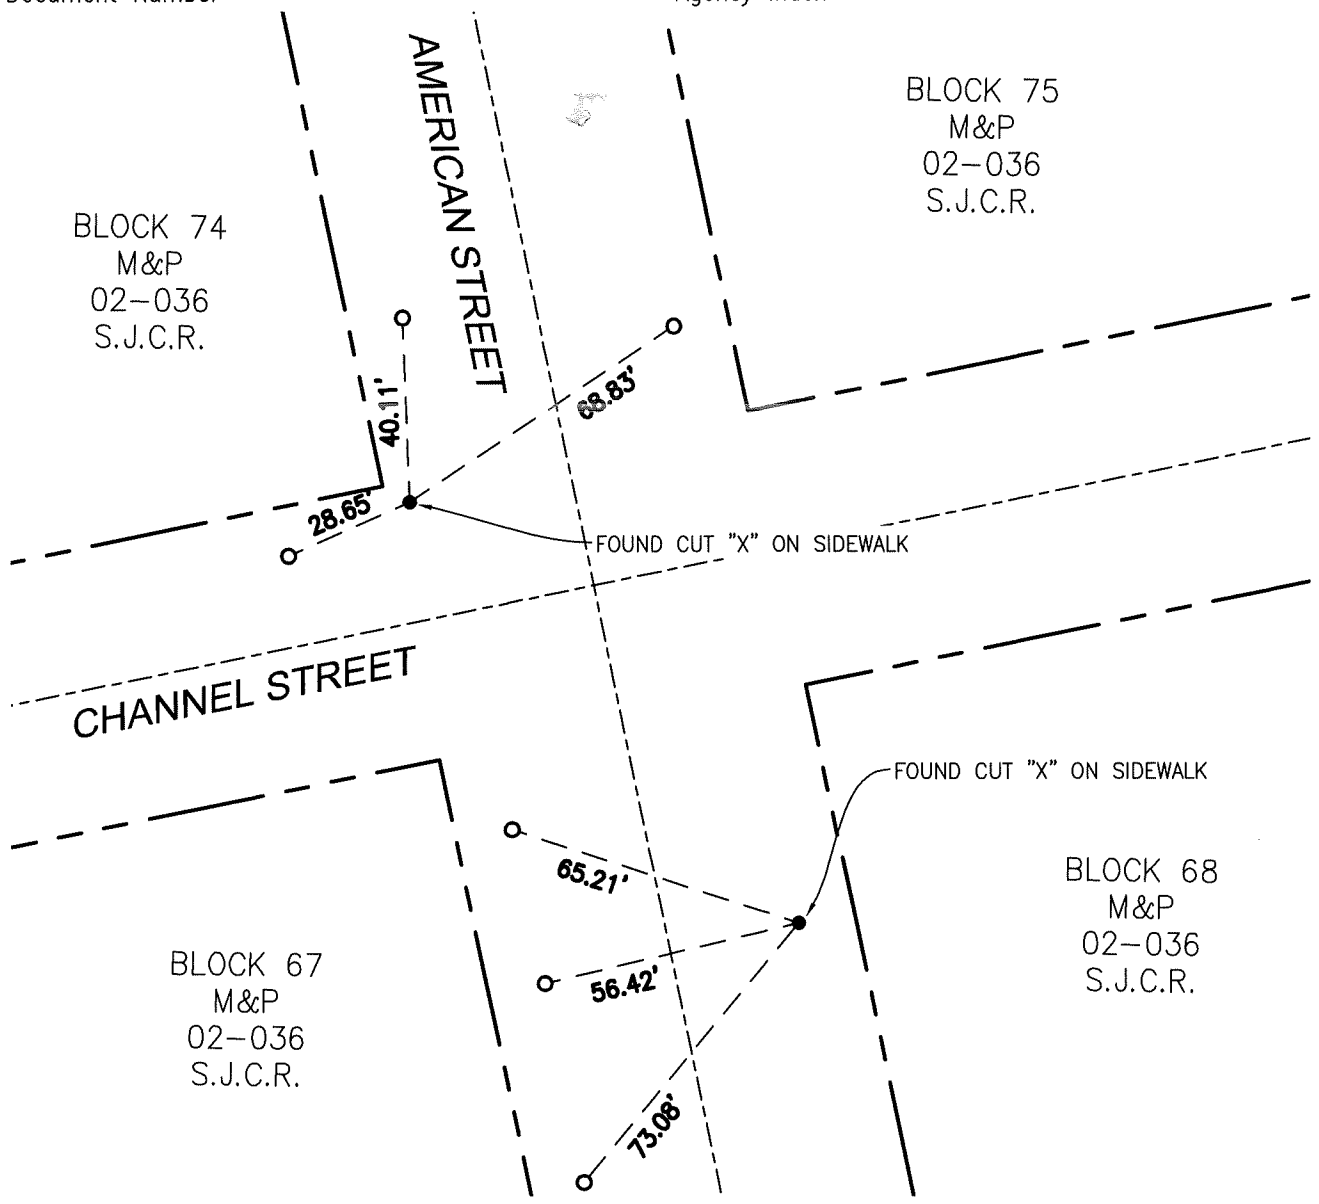

LEGEND:

S.J.C.R.	SAN JOAQUIN COUNTY RECORDS
●	SET MONUMENT AS NOTED
o	SET SCRIBED X
M&P	MAPS AND PLATS, BOOK AND PAGE

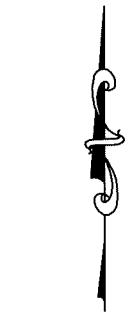

SCALE IN FEET

0 40'