

CORNER RECORD

COUNTY OF San Joaquin T. 3 N R. 7 E M.D.B. & M. MERIDIAN CALIFORNIA
 CORNER TYPE: GOV'T. CORNER ☒ MEANDER ☐ RANCHO ☐ CONTROL ☐ OTHER ☐
 CORNER IDENTIFICATION - DATE OF VISIT Dec. 18 19 74

S	S
11	12
S	S
14	13

CORNER - LEFT AS FOUND ☒ FOUND AND TAGGED ☐ REESTABLISHED OBLITERATED CORNER ☐ RESULT ☐

PHYSICAL DESCRIPTION OF CORNER FOUND: EVIDENCE AND METHOD USED TO IDENTIFY OR REESTABLISH

5/8" Bolt with 2 1/2" Brass washer, flush with Rd. surface punched and stamped
 S.J. Co., Surveyor, Ls 2239. Located: 5²⁺ S/O Kettleman Rd. CL and 19⁰⁺ N/O B.M.
 C.A. -66 Azim. 1961 Located by visual contact.

PHYSICAL DESCRIPTION OF MONUMENTS RESULT OR PERPETUATED

CALIFORNIA COORDINATE SYSTEM ORDER: FIRST ☐ SECOND ☐ THIRD ☐
 STATIONS USED: NGS (USC & GS) ☐ STATE ☐ COUNTY ☐ OTHER ☐ STATION _____ STATION _____
 ZONE _____ ELEVATION _____ NORTHINGS (Y) _____ EASTINGS (X) _____


SKETCH: (Include reference tie or witness points, remarks and topo of area)

Set Nail: Shiner & Base
 of R.G.E. Burn Pole O/I.O. Nails
 39 43 N 10° W

Set Nail: Shiner & Base of
 R.G.E. Stub Pole S/O Rd.
 20" S 98 W

Corner of Engineer U.S. Army B.M.
 CA-66 AZIM 1961 18° South

PACIFIC GAS AND ELECTRIC CO.
 LAND DEPT. JOB 18-11

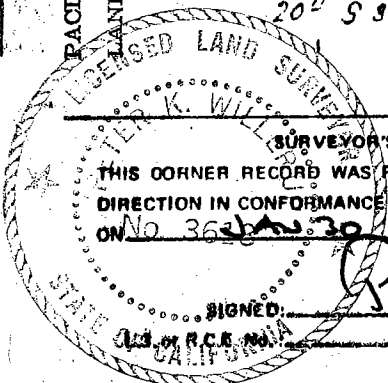

SURVEYOR'S CERTIFICATE
 THIS CORNER RECORD WAS PREPARED BY ME OR UNDER MY
 DIRECTION IN CONFORMANCE WITH THE LAND SURVEYORS ACT
 ON No. 3618 19 75

SIGNED: Peter K. Willers
 Ls 2618

SEAL

COUNTY SURVEYOR'S CERTIFICATE
 THE CORNER RECORD WAS RECEIVED MARCH 19 19 75
 AND EXAMINED AND FILED MARCH 21 19 75

BY: Chief Deputy County Surveyor
 TITLE: CR-75-005

DOCUMENT No. CR-75-005

STATEMENT ON BACK OF SHEET

YES ☐

NO ☒