


CORNER RECORD

COUNTY OF San Joaquin T. 3 N R. 7 E M.D.B. M. MERIDIAN CALIFORNIA

CORNER TYPE: GOV'T. CORNER ☐ MEANDER ☐ RANCHO ☐ CONTROL ☐ OTHER ☐

CORNER IDENTIFICATION - DATE OF VISIT Dec. 18 19 74

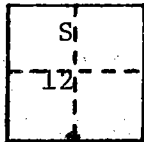

South 1/4 cor. of Sec. 12

CORNER - LEFT AS FOUND ☒

FOUND AND TAGGED ☐

REESTABLISHED OBLITERATED CORNER ☐

REBUILT ☐

PHYSICAL DESCRIPTION OF CORNER FOUND; EVIDENCE AND METHOD USED TO IDENTIFY OR REESTABLISH

5/8" bolt with 2 1/2" brass washer flush with rd. surface punched and stamped S.J. Co. Surveyor Ls 2239. Located 2°+ S/O Kettleman Road CL and 12°+ E/O Twin 30" Culverts.

PHYSICAL DESCRIPTION OF MONUMENTS REBUILT OR PERPETUATED

CALIFORNIA COORDINATE SYSTEM ORDER: FIRST ☐

SECOND ☐

THIRD ☐

STATIONS USED: NGS (USC & GS) ☐

STATE ☐

COUNTY ☐

OTHER ☐

STATION _____

STATION _____

ZONE _____


ELEVATION _____

NORTHINGS (Y) _____


EASTINGS (X) _____

SKETCH: (Include reference tie or witness points, remarks and topo of area)

*P.G. & E. Lockford
Substation
Punch Mark 3" D
Steel post*

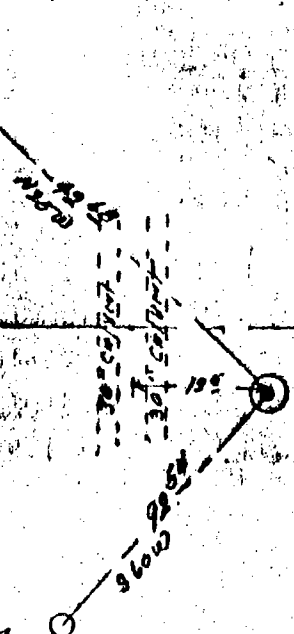

PACIFIC GAS AND ELECTRIC CO.
LAND DEPT. JOB 16.3.290

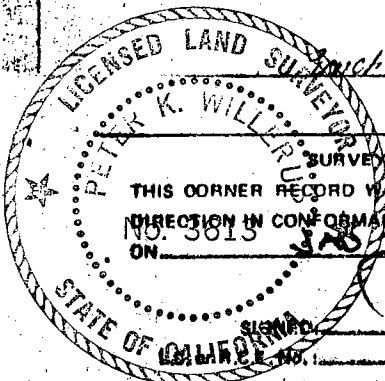

SURVEYOR'S CERTIFICATE

THIS CORNER RECORD WAS PREPARED BY ME OR UNDER MY DIRECTION IN CONFORMANCE WITH THE LAND SURVEYORS ACT

ON NOV 21 19 75

SIGNED

P. K. Willer


SEAL

COUNTY SURVEYOR'S CERTIFICATE

THE CORNER RECORD WAS RECEIVED MARCH 19 19 75
AND EXAMINED AND FILED MARCH 21 19 75

BY Robert J. Williams

TITLE: Chief Deputy County Surveyor

DOCUMENT No. CR-75-007

STATEMENT ON BACK OF SHEET

YES ☐

NO ☒

✓