


CORNER RECORD

COUNTY OF San Joaquin T. 3N R. 8E MDB& MERIDIAN CALIFORNIA

CORNER TYPE: GOV'T. CORNER ☒ MEANDER ☐ RANCHO ☐ CONTROL ☐ OTHER ☐

CORNER IDENTIFICATION — DATE OF VISIT April 30 19 76

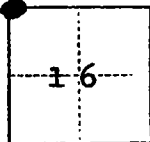

CORNER — LEFT AS FOUND ☐ FOUND AND TAGGED ☒ REESTABLISHED OBLITERATED CORNER ☐ REBUILT ☐

PHYSICAL DESCRIPTION OF CORNER FOUND; EVIDENCE AND METHOD USED TO IDENTIFY OR REESTABLISH

Found 1 1/8 inch iron pin 0⁷ feet down at center of Kettleman Lane and Intersection of North-South fences. Set tag LS 3576. Set 1 inch X 2 inch with tack flush with pavement and 4 shiners N-S. and E-W. four feet apart, also set R.P.'s as shown in sketch. To find used plat of Lockeford Tokay Colony - filed in Volume 6, Page 16.


PHYSICAL DESCRIPTION OF MONUMENTS REBUILT OR PERPETUATED

CORNER LOCATED BY P.G.&E. SURVEY
BUT NOT VERIFIED

PACIFIC GAS AND ELECTRIC CO.
LAND DEPT. JOB 183341

CALIFORNIA COORDINATE SYSTEM ORDER: FIRST ☐ SECOND ☐ THIRD ☐
STATIONS USED: NGS (USC & GS) ☐ STATE ☐ COUNTY ☐ OTHER ☐ STATION _____ STATION _____
ZONE _____ ELEVATION _____ NORTHINGS (Y) _____ EASTINGS (X) _____

SKETCH: (Include reference tie or witness points, remarks and topo of area)

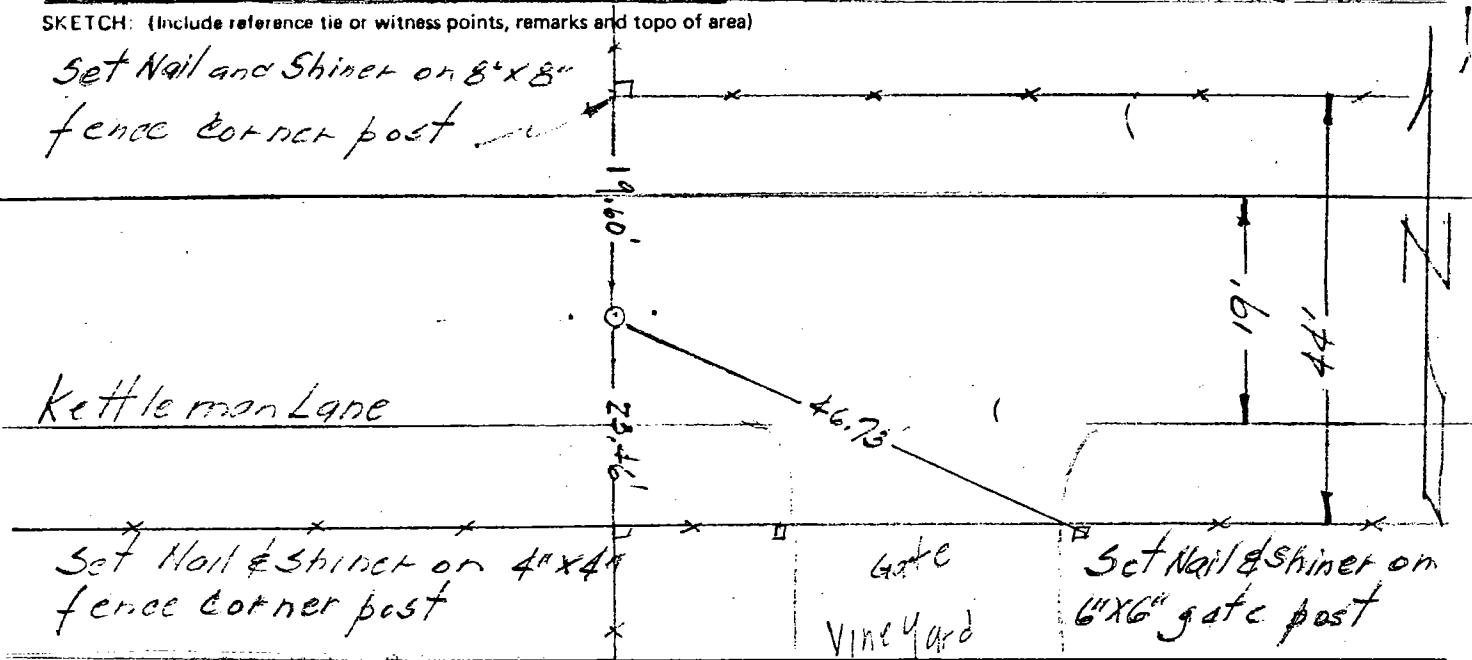

SURVEYOR'S CERTIFICATE

THIS CORNER RECORD WAS PREPARED BY ME OR UNDER MY DIRECTION IN CONFORMANCE WITH THE LAND SURVEYORS ACT

SIGNED: _____

ES. or R.C.E. No.: _____

No. 3613

SEAL

COUNTY SURVEYOR'S CERTIFICATE

THE CORNER RECORD WAS RECEIVED May 25, 1976
AND EXAMINED AND FILED June 3, 1976

BY: Robert D. Dumanek

TITLE: Chief Deputy County Surveyor

DOCUMENT No. C.R.-76-007

STATEMENT ON BACK OF SHEET

YES ☐ NO ☒

