

**R-M-S**  
PROFESSIONAL CONSULTANTS, INC.


BY: J.W	CLIENT: STANLEY KEENAN JOB NO. 13635 10-24-78	PROJECT: PROPERTY LINE SURVEY	SUBJECT: FENCE RELOCATION	1 1
------------	---	-------------------------------------	------------------------------	--------

REPLACEMENT OF LOST  
SURVEY MARKER  
FROM BOOK OF SURVEYS  
VOL. 7 PAGE 145

CORNER RECORD RECEIVED OCT. 26., 1978  
EXAMINED & FILED OCT. 31, 1978  
BY Robert M. Schramm  
TITLE Chief Deputy County Surveyor  
DOCUMENT NO. CR-78-001



FREMONT ST.

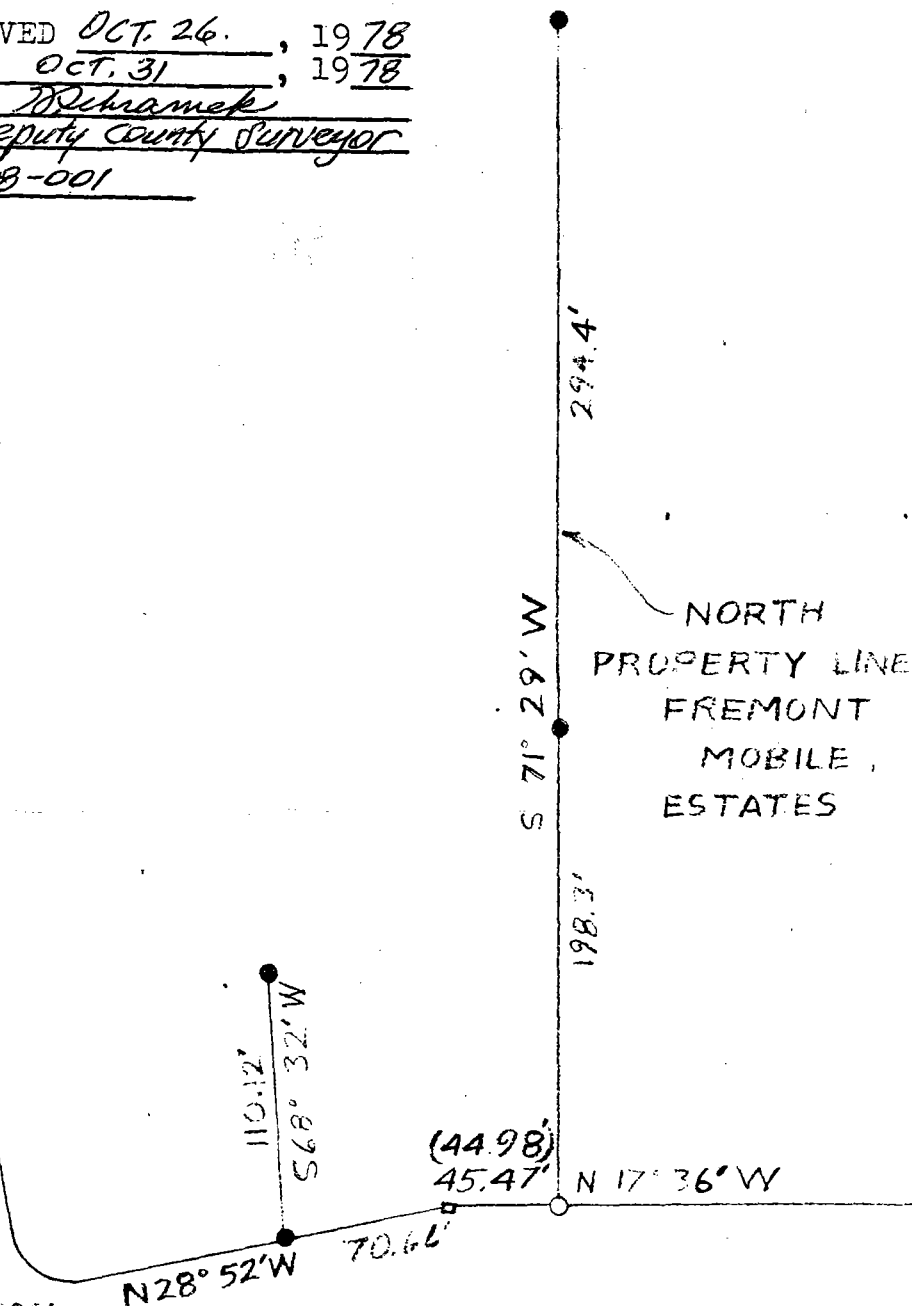

(XX.XX') MAP DIMENSION

● FOUND IRON PIN

○ REPLACED IRON PIPE MARKED WITH BRASS TAG NO. 19,065

□ REPLACED WOOD HUB

FILBERT ST

DOCUMENT NO. CR-78-001